APR 30 1970

RESOLUTION OF ABANDONMENT

WHEREAS, THE NAVAJO COUNTY BOARD OF SUPERVISORS, in meeting assembled this date, have determined that the following described roadways are no longer necessary for public use as a roadway, and

WHEREAS, it is the desire of the said Navajo County Board of Supervisors to dispose of said property pursuant to the provisions of A.R.S. §18-502.

NOW, THEREFORE, IT IS HEREBY RESOLVED that the portion of U. S, Route 66 and State Highway Route 65, as shown in red on the plats attached hereto and incorporated herein, and which were abandoned by the State of Arizona on the 20th day of January, 1970, as recorded in the official records of the Recorder's Office of Navajo County in Docket 316, Pages 823 through 834 thereof, be and the same are hereby abandoned as a public roadway, and title to said property shall vest in the owners of the abutting land, pursuant to the law.

IN WITNESS WHEREOF, we have hereunto set our hand this 4th day of May, 1970.

NAVAJO COUNTY BOARD OF SUPERVISORS

M. J. O'Haco
Chairman

William M. Smith

May E. Taylor
Members

ATTEST:

Marcella Truitt
Clerk of the Board of Supervisors

MICROFILMED
INDEXED

#3109
FILED AND RECORDED AT THE REQUEST OF
Navajo County Board of Supervisors
May 5, A. D. 19 70 AT 2:29 O'CLOCK P.M.
IN DOCKET 321, Off. Records PAGES 355-361, Inclusive
RECORDS OF NAVAJO COUNTY, ARIZONA
Guy D. Hurley RECORDER

Min 5-4-70
Page 234
Book 13

DOCKET 321 PAGE 355

Abandonment Sketch

R/W to be abandoned 50' Lt. and 50' Rt. of ℄

Sec. 8 T18N-R18E G&SR-B&M

Proj. I 40-4(16)

See Sheets 5, 6, 7.

DOCKET 316 PAGE 826

DOCKET 321 PAGE 356

Abandonment Sketch
R/W to be abandoned 50' Lt & 50' Rt of ℄
Sec. 9 T18N-R18E G&SR-B&M.
Project I40-4(16)
See Sheet No 8 of Project Plans

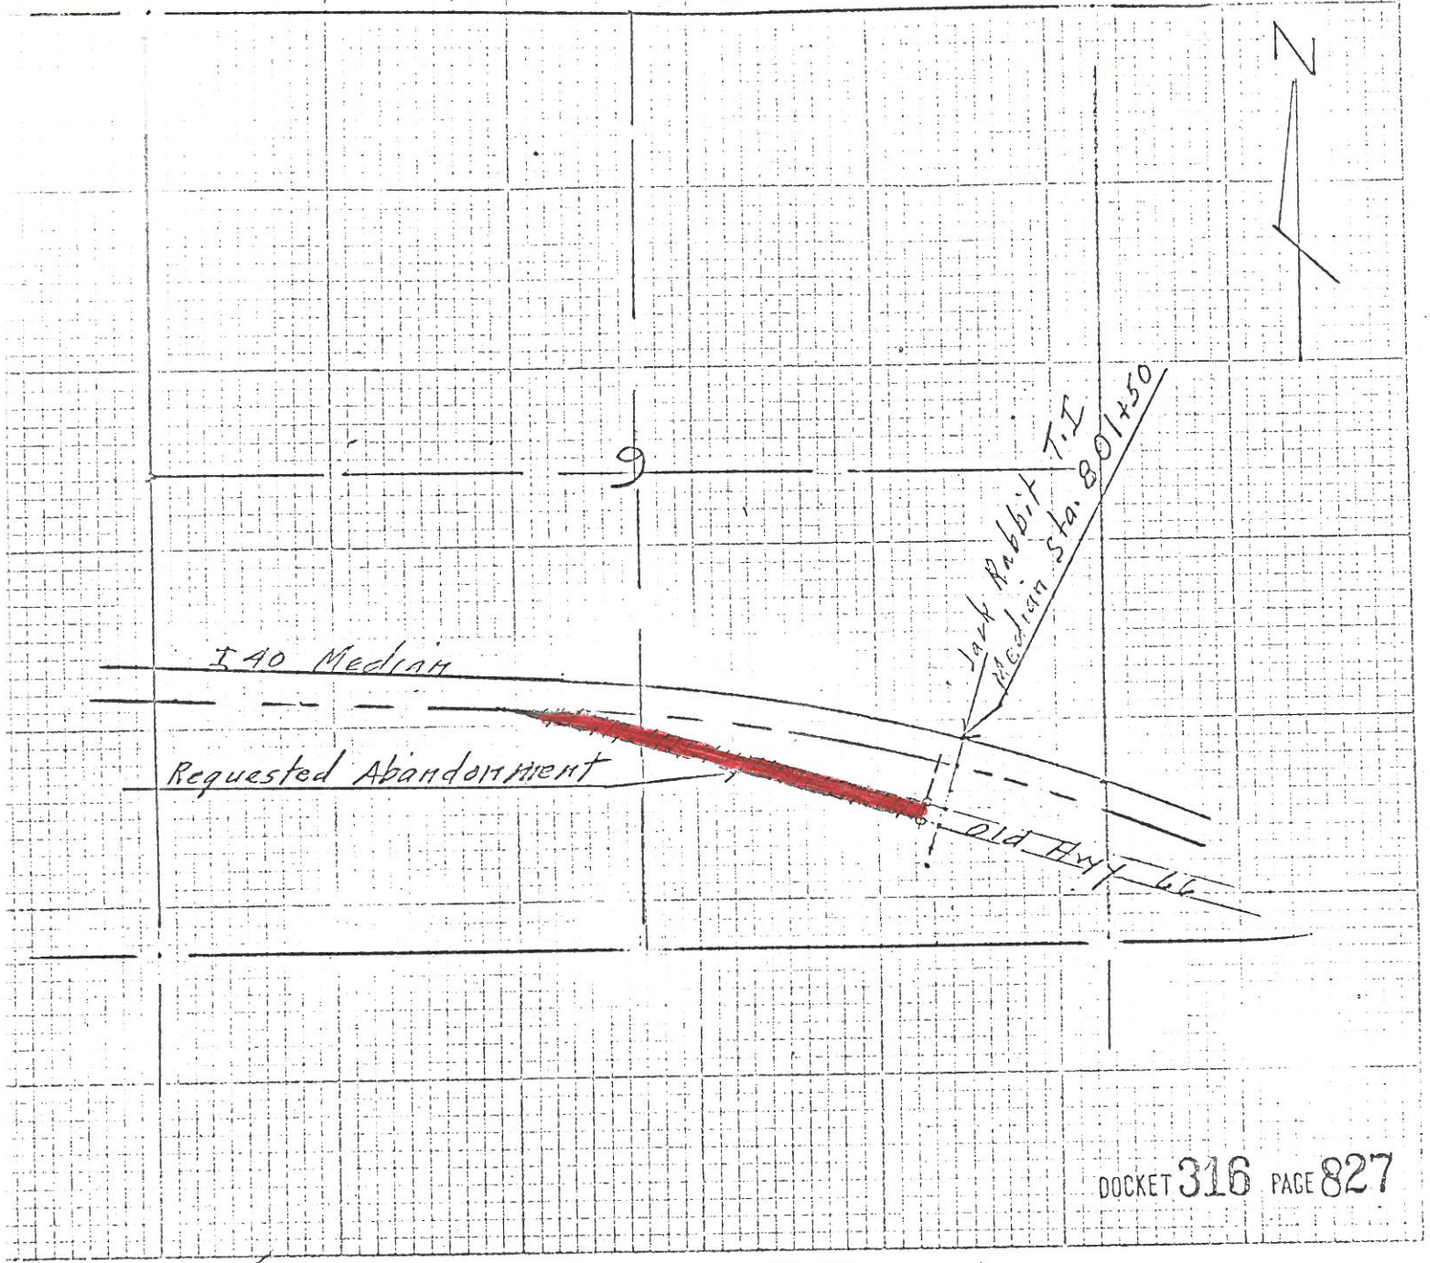

DOCKET 316 PAGE 827

EUGENE DIETZGEN CO. NO. 375

DOCKET 321 PAGE 357

Abandonment Sketch

R/W to be abandoned 50' Rt. and 50' Lt. of ℄

Sec. 25 T18N-R19E G℄SR-B&M

Project I 40-4 (23)

Sheet No. 17 and 19

DOCKET 316 PAGE 828

DOCKET 321 PAGE 358

Abandonment Sketch

R/W to be abandoned 50' Lt. and 50' Rt. of ℄

Sec. 32 T18N - R20E 6℄SR B&M

Proj I-40-4 (23)

See sheet No 25, 27, and 29

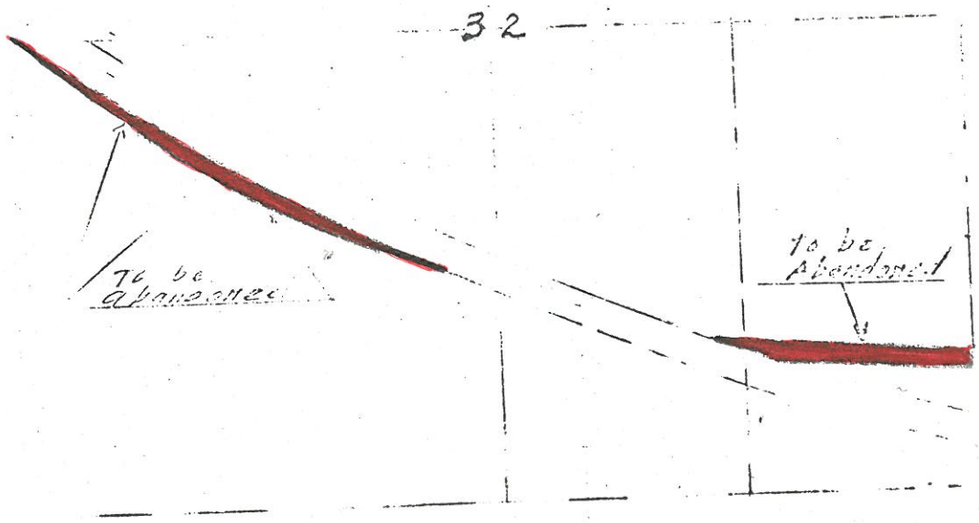

DOCKET 316 PAGE 829

DOCKET 321 PAGE 359

Abandonment Sketch
RIW to be abandoned 50' Lt and 50' Rt of ℄
Sec 33 T18N-R20E and
a portion of Sec. 4 T17N-R20E G&SR. B&M.
Project I 40-4 (23)
Sheet No. 29, 31, and 32

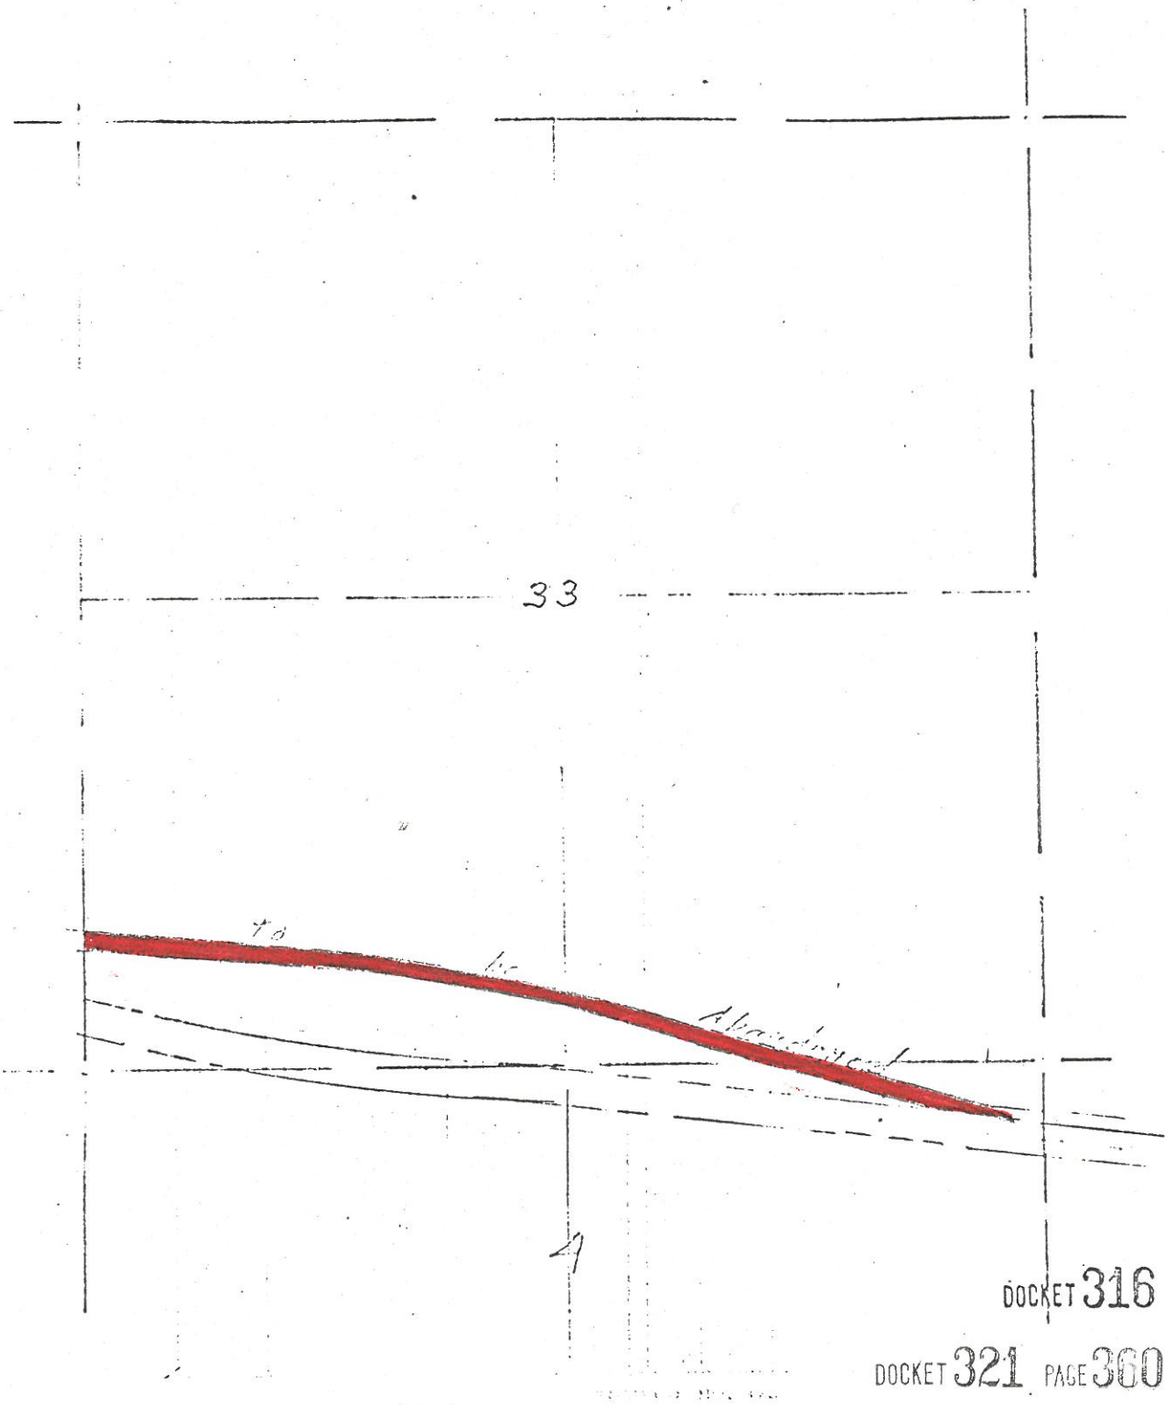

DOCKET 316 PAGE 830
DOCKET 321 PAGE 360

DOCKET 316 PAGE 834

DOCKET 321 PAGE 361